COUNTY OF LOS ANGELES DEPARTMENT OF PUBLIC WORKS BUILDING AND SAFETY / LAND DEVELOPMENT

EAST LA 4801 3RD ST

LOS ANGELES CA 90022 PHONE: (323) 881-7030 EXT: # 0600

BUILDING PERMIT SIGN BL 0600 1106230022

LEGAL ID: NUMBER OF SIGNS: 1 BUILDING ADDRESS: TR: 6227 LT: 1 BL: .001 UN: .002 SIGN DESCRIPTION: 14' 1/2" X 6'03/4" 4512 CESAR CHAVEZ AV LOSA CA 900221117 ASSESSOR INFORMATION NUMBER: NEAREST CROSS STREET: 5235-005-002 THOMAS PAGE: 635 GRID: F5 LOCALITY: LOS ANGELES TENANT: EXIST BLDG USE: ISSUED ON: PROCESSED BY: EXIST OCC GRP: 06/23/11 T.C. OWNER: TEL. NO: BLDGS. NOW ON LOT: VALUATION: FINAL DATE FINAL BY: CODE: HUERTA, MAGDALENA M TR 6,000 4514 E CESAR CHAVEZ LOS ANGELES, CA FEES PAID DESCRIPTION OF WORK ONE SET OF CHANNEL LETTERS "CITIES RESTAURANT" FFE DESCRIPTION: QUANTITY: UOM: AMOUNT: | 14'8 1/2" X 6'3/4" APPLICANT: TEL. NO: PABLO MORALES (323) 270-5977-AA BLDG PERMIT ISSUANCE 26.60 10151 PESCADERO AVE AB STATE GREEN BLDG FEE 6000.00 VAL 1.00 | SPECIAL CONDITIONS: SOUTH GATE, CA 90280 AE STRONG MOTION OTHER 6000.00 VAL 1.30 D1 PLANCHECK W/O EN-HC 6000.00 VAL 122.10 D2 PERMIT W/O EN-HC 6000.00 VAL 143.70 CONTRACTOR: TEL. NO: TOTAL FEES 294.70 APPROVALS DATE INSPECTOR SIGNATURE MORALES SIGN CO. (323) 855-0643-10151 PESCADERO AVE LIC. NO LOCATION AND SETBACKS SOUTH GATE, CA 90280 912596 C45 SOILS ENGINEER APPROVAL ARCHITECT OR ENGINEER: TEL. NO: FOUNDATION/TRENCH FORMS LIC. NO: SUPPORT STRUCTURE MAP NO: SEWER MAP BOOK: PAGE: FIRE ZONE: CMP: NO. OF FAMILIES: DWELLING UNITS: APT/COND: STAT CLASS: SCHOOL WITHIN HAZARDOUS AIR QUALITY: 1000 FEET MATERIALS NO NO REPORT ID: DPR261 ROUTE TO: BS0600

OWNER-BUILDER DECLARATION

I hereby affirm under penalty of perjury that I am exempt from the Contractors' State License Law for the reason(s) indicated below by the checkmark(s) I have placed next to the applicable item(s) (Section 7031.5, Business and Professions Code): Any city or county that requires a permit to construct, alter, improve demolish, or repair any structure, prior to its issuance, also requires the applicant for the permit to file a signed statement that he or she is licensed pursuant to the provisions of the Contractors' State License Law (Chapter 9 (commencing with Section 7000) of Division 3 of the Business and Professions Code) or that he or she is exempt from licensure and the basis for the alleged exemption. Any violation of Section 7031.5 by any applicant for a permit subjects the applicant to a civil penalty of not more than five hundred dollars (\$500).):

(_) I, as owner of the property, or my employees with wages as their sole compensation, will do (√) all of or (_) portions of the work, and the structure is not intended or offered for sale (Section 7044, Business and Professions Code: The Contractors' State License Law does not apply to an owner of property who, through employees' or personal effort, builds or improves the property, provided that the improvements are not intended or offered for sale. If, however, the building or improvement is sold within one year of completion, the Owner-Builder will have the burden of proving that it was not built or improved for the purpose of sale.).

(_) I, as owner of the property, am exclusively contracting with licensed Contractors to construct the project (Section 7044, Business and Professions Code: The Contractors' State License Law does not apply to an owner of property who builds or improves thereon, and who contracts for the projects with a licensed Contractor pursuant to the Contractors' State License Law).

(_) I am exempt from licensure under the Contractors State License Law for the following reason:

By my signature below I acknowledge that, except for my personal residence in which I must have resided for at least one year prior to completion of the improvements covered by this permit, I cannot legally sell a structure that I have built as an owner-builder if it has not been constructed in its entirety by licensed contractors. I understand that a copy of the applicable law, Section 7044 of the Business and Professions Code, is available upon request when this application is submitted on at the following Web site: http://www.leginfo.ca.gov/calaw.html.

Jaie			
Signature of Property	Owner or	Authorized	Agent

D-4-

LICENSED CONTRACTOR'S DECLARATION

I hereby affirm under penalty of perjury that I am licensed under provisions of Chapter 9 (commencing with Section 7000) of Division 3 of the Business and Professions Code, and my license is in full force and effect.

License Class C-45 License No. 912596

Date 6-23-1 Contractor Signature 1

WORKERS' COMPENSATION DECLARATION

WARNING: FAILURE TO SECURE WORKERS' COMPENSATION COVERAGE IS UNLAWFUL, AND SHALL SUBJECT AN EMPLOYER TO CRIMINAL PENALTIES AND CIVIL FINES UP TO ONE HUNDRED THOUSAND DOLLARS (\$100,000), IN ADDITION TO THE COST OF COMPENSATION, DAMAGES AS PROVIDED FOR IN SECTION 3706 OF THE LABOR CODE, INTEREST, AND ATTORNEY'S FEES.

I hereby affirm under penalty of perjury one of the following declarations:

| ____ | have and will maintain a certificate of consent to self-insure for workers' compensation, issued by the Director of Industrial Relations as provided for by Section 3700 of the Labor Code, for the performance of the work for which this permit is issued.

Policy No.

Carrier

I have and will maintain workers' compensation insurance, as required by Section 3700 of the Labor Code, for the performance of the work for which this permit is issued. My workers' compensation insurance carrier and policy number are:

Policy Number Expiration Date

Name of Agent

Phone Number

____ I certify that, in the performance of the work for which this permit is issued, I shall not employ any person in any manner so as to become subject to the workers' compensation laws of California, and agree that, if I should become subject to the workers' compensation provisions of Section 3700 of the Labor Code. I shall forthwith comply with those provisions

Signature of Applicant

6-23-11 Date

LOBBYIST ORDINANCE CERTIFICATION Complete this section for permits in Unincorporated Los Angeles County only

This is to certify that I, as permit applicant, am familiar with the requirements of Los Angeles County Code Chapter 2.160 et seq., (relating to the Los Angeles County Lobbyist Ordinance) and that all persons acting on behalf of myself complied and will continue to comply therewith through the application process.

Peblo Movole
Applicant (Print Name)

Applicant Signature

Date

Company Name

Date

JOB ADDR	ESS			*	
LOCALITY					
Will the appropriate or	HAZARDOUS MA blicant or future bu a mixture containi in the amount spi guide?	uilding o	occupant h azardous r	andle a h naterial e	qual to o
Yes 🗌		Νo			
building o	ended use of the occupant require n from the South CAQMD)? See po	a p Coas	ermit for t Air Qua	constru ality Man	ction o agemen
Yes		Νo			
SCAQMD under the Sections	d the hazardous permitting checkl Los Angeles Co 220.100 through porting and for obt	ist, I o ounty (220.	understand Code Title 140 conc	my reques 2, Cha erning h	uirement: pter 220 azardou:
	ASBESTO	S NOT	TFICATION	N	
☐ Notific	cation letter sent to	o AQM	D and/or E	PA	
	are that notificatio			noval is no	ot
DECLARA AGENCY	TION REGARDIN	IG COI	NSTRUCT	ION LEN	DING
Construction	affirm under pe on lending agency permit is issued (\$	for the	e performa	nce of the	ere is e work fo
Lender's N	lame				
Lender's A	ddress				
I am the property of I have reprovided I agree ordinance construct I authorizabove-ide	5)5 51111	er or tion a all a law ves of	authorize nd the in pplicable rs relation this couspection p	formation city and to act of the city and to act of the country to accomplishing to accomplishing to accomplishing to accomplishing to accomplishing the country	t on th n I hav d count buildin

APPLICANT'S COPY K 0 Z \triangleleft Z O Ш > _ NNOVA

DEPARTMENT OF REGIONAL PLANNING APPROVED

THIS APPROVAL IS CONTINGENT UPON THE FACTS

REA201100173 AND COUNTY ZONING

JRDINANCE TITLE 22 OF THE LOS ANGELES COUNTY CODE IN EFFECT AT THIS TIME. IT IS APPLICABLE ONLY AS SPECIFICALLY NDICATED HEREIA. SUCH APPROVAL SHALL NOT BE CONSTRUED TO 'ERMIT THE VIOLATION OF ANY PROVISION OF ANY COUNTY



Los Angeles County Department of Regional Planning

DO NOT REMOVE



Project No: R200503044 REA 201100173 Address: 4512 E. Cesar Chavez Ave

te: 6/22/2011

This Revised Exhibit "A" (REA) approves the following changes to the Exhibit "A" for the above

Revised signage font for the CITIES Restaurant. New signage is a total of 144.44sq. ft with the

This REA is found to be in substantial compliance with the terms and conditions of the above references project approval. All permit conditions remain in effect and are not altered by this revision.

4512 E. Cesar E. Chavez Ave., Los Angeles, CA 90022




Tel. 323.270.5977

Photo rendition for representational purposes only. Photo scales are close approximate. Actual sign may appear larger or smaller than shown. Color shown may vary due to ink jet printing interpretations.

APPLICANT'S COPY




JUN 21 2011

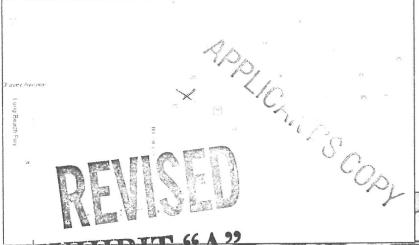

C I T I E S Restaurant

4512 E. Cesar E. Chavez Ave., Los Angeles, CA 90022

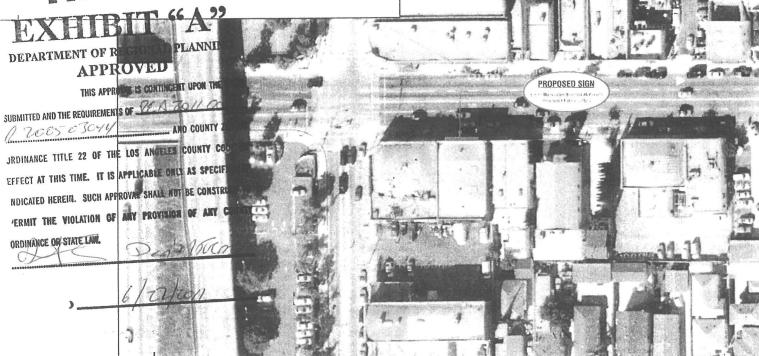



Website: www. Meralessigns.co Phone: 323.270.5977 • e-mail: tany: imaralessigns.co

SALESMAN:

Tony Moratus

PROJECT MANAGER

Name

DRAWING BY

R. T. Furgay

CUSTOMER APPROVAL

00.00

V. No. DATE

Reason of ravision 00-00-11

4 Reason at revision 00-00-11

5 Reason of revision 00-00-17 R

Reason of revision 00-00-07 R

JOB TITLE: CITIES RESTAURANT

JOB ADDRESS 4512 E. Cosar E. Chavez Avan Los Angoles, CA 90022

SHEET TITLE

JOB NAME

Citios Restaurant_sign 05-26-2011

05.26.11

SITE PLAN

SCALE A. Norm

SHEET No.

PG.2

All ideas, plans, or arrangements indicated on this drawing are copyrighted and owned by Morales Signs and shall not be reproduced, used by or disclosed to any persons, firm or corporation for any purpose whatsoever without written permission of Morales Signs.

SITE : VICINITY MAP

Scale: NTS

DEPARTMENT OF REGIONAL PLANNING

THIS APPROVAL IS CONTINGENT UPON THE FACTS

Manufacture & Install One (1) Set L.E.D. Illuminated Brushed Aluminum Reversed Channel Letters 1" PAPER MED. The External Fascia PROPOSED SIGN Scale: 3/8" = 1'-0'

6'-0 3/4"

50'-0 "


28'-6 1/2"

SUBMITTED AND THE REQUIREMENTS OF . R 2005 03044

AND COUNTY ZONING

JRDINANCE TITLE 22 OF THE LOS ANGELES COUNTY CODE IN EFFECT AT THIS TIME. IT IS APPLICABLE ONLY AS SPECIFICALLY

NDICATED HEREIN. SUCH APPROVAL SHALL NOT BE CONSTRUED TO

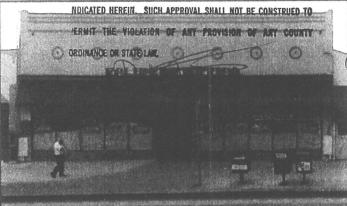

FRONT BUILDING ELEVATION
Scale: 1/8" = 1'-0"

2 EXISTING CONDITION 3 Scale: NTS

SALESMAN:

ROJECT-MANAGER:

CUSTOMER APPROVAL

00-00-11 RTF

JOB TITLE: CITIES RESTAURANT


JOB ADDRESS 4512 E. Cosar E. Chaver Avenue Los Angutos, CA 90022

SHEET TITLE: PROPOSED SIGN

05.26.11 SCALE

PG.3

All ideas plans, or arrangements indicated on this drawing are copyrighted and owned by Morale Signs, and shall not be reproduced, used by or disclosed to any persons, fum or corporation for any purpose whatsoever without written permission of Morales Signs

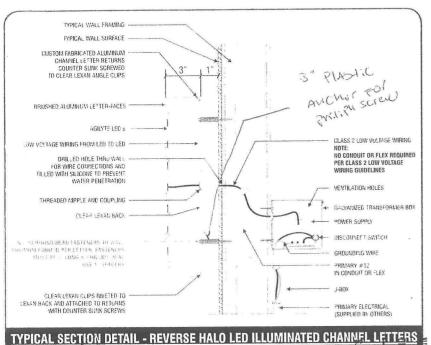

SECTION DETAIL
Scale: NTS

·IFD	REVERSE	HAIO	ILLUMINATED	CHANNEL	LETTERS

- ALUMINUM FACE
- MOUNTED 1" AWAY FROM WALL SURFACE
- REMOTE POWER SUPPLY

ALTERNATE ATTACHMENT METHODS

HARDWARE	RE BUILDING CONSTRUCTION			
MINIMUM FASTENERS	MASONRY	W00D	METAL / ACM	PLYWOOD / EFIS
14" BOLTS THRU WALL	Х	X	Х	REQUIRES BLOCKING BY INSTALLER
"4" LAG BOLTS W/SHIELD	X	****		
74" LAG BOLTS		Х	***	REQUIRES BLOCKING BY INSTALLER
1/4" TOGGLE BOLTS	HOLLOW BLOCK ONLY		Х	THRU BOTH PLYWOOD AND EFIS MATERIAL

Note to All Contractors

120 Sign Voltage

BE CONSTRUED TO

SUCH APPROVAL

AS

IS APPLICABLE

EFFECT AT

108

9

APPROVAL IS CONTINGENT UPON

SUBMITTED AND THE REQUIREMENTS OF

REGIONAL

OF

DEPARTMENT

PPROVED

ANY

40

PROVISION

ANY

능

NO

VIOLATI

'ERMIT

OR

This sign is intended to be installed in accordance with the requirements of Article 600 of the National Electrical Gode and/or other applicable local codes. This includes proper grounding and bending of the sign.

All wall genetrations to be sealed with UL Listed silicone scalant.

NOTE: MFG. / U.L. LABELS ON TOP OF LETTERS MAY NOT BE VISIBLE

BUILDING AND SAFETY DIVISION
Department of Public Works
APPROVED
UNDSATITLE 26

v. 01455

JUN 22 20

This set of clara and specifisations must be kept on the job at all times and it is unlawful to make any Changes or alterations on same without written permission from the Building and Safety Division, County of Los Angeles. The stamping of this plan and specification SHALL NOT be held to permit or to be an approval of the violation of any provisions of any County Ordinance or State Law

4512 F. Cera Chars

Website www. Maralessigns.ce Phone. 325.276.5917 • e-mail: tenyi Dinaridessigns.com

SALESMAN:

PROJECT MANAGER

Verne

DRAWING BY:

R. T. Furngay

CUSTOMER APPROVAL

00.00.11

EV. No. DATE.

2 Reason of revision 00-60-11 R

Reason of revision 00-00-11 R

Russon of revision 00-00-11

Reason of revision 00-00-11 RT

Reason of revenior. 00-00-07

JOB TITLE: CITIES RESTAURANT

JOB ADDRESS 4512 E. Curar E. Crincos Avenue, Los Angulos, CA 90022

SHEET TITLE PROPOSED SIGN

JOB NAME

Cities Rosesurant_sign 05-26-2011

DATE: 05.26.11

SCALE:

As Norma

SHEET NO. PG.4

All ideas, plans, or arrangements indicated on this drawing are copyrighted and owned by Morales Signs and shall not be reproduced, used by or disclosed to any persons. If irm or corporation for any purpose whatsoever without written permission of Morales Signs.

APPLICANT'S COPY